


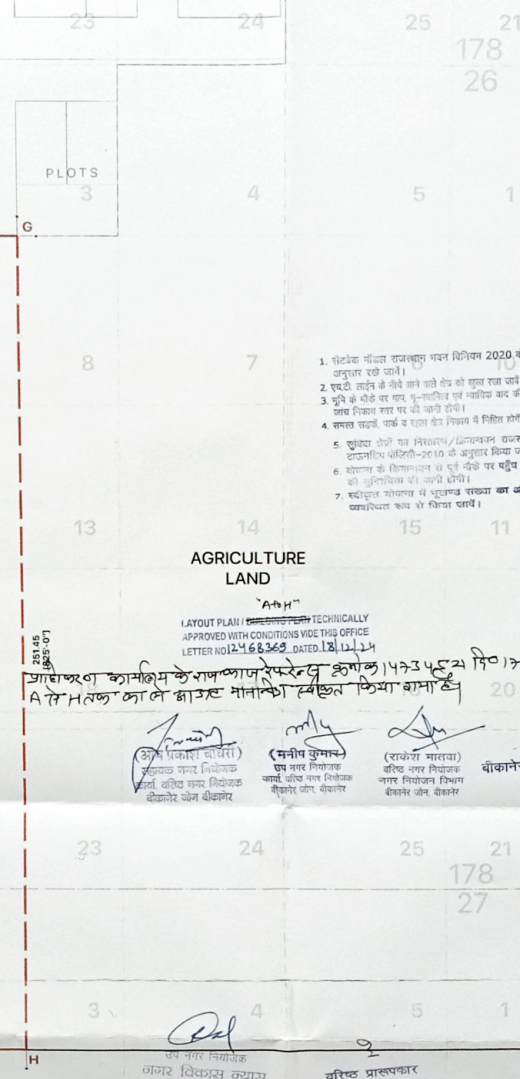

AGRICULTURE
LAND

LAYOUT PLAN / ~~DESIGN~~ / ~~PERM~~ / TECHNICALLY
APPROVED WITH CONDITIONS VIDE THIS OFFICE
LETTER NO. 12468369 DATED 18/11/12

151.45
25.07

263 450
263 450
263 450
APPROVED BY THE COMMISSIONER
LETTER NO. 12/68369 DATED 18/11/24
प्रा.रा.अ. का.म.सि. के.रा.म.का.ज.से.पे.रे.सु. अंका. 1473452 दि. 17/04/2025 के मा.ए.प. से मा.पे.रा.का.
A से महक.का.ले.डा.उ.र. माना.का.ले.ख.न किया गया है। 20

(अभि प्रकाश चौधरी)
सहायक जनर निदेशक
आर्या, वरिष्ठ जनर निदेशक
वीरगंज जिला वीरगंज

(मनीष कुमार)
उप नगर नियोजक
कार्यालय, पश्चिम नगर निगम
बीकानेर जिला, बीकानेर

(राकेश मातया)
वरिष्ठ नगर नियोजक
नगर नियोजन विभाग
बीकानेर जोन, बीकानेर

सचिव
बीकानेर विकास प्राधिकरण

☐ - FWS/L36 PLATS

PROJECT TITLE:

PROPOSED RESIDENTIAL SCHEME
BRINDAVAN KRISHNA
MOHAN ENCLAVE

CHAK-11 B.S.M., M. No. - 178/10, KILLA No. - 15, 16,
M. No. - 178/18, KILLA No. - 8 (Part), 9, 11, 12, 13 (Part), 18
(Part), 19, 20, 21, 22, 23 (Part); CHAK-12 B.S.M., M. No. -
178/9, KILLA No. - 1, 2, 3 (Part),
VILL. - UDASAR, TEH. & DIST. - RIKANER

VILL. - UDASAR

ARCHITECTS SEAL & SIGN
MOHAMMAD KHALID USTA
Ahmed Manzil,
Jeddah, Ustas,
AR. MOHAMMAD KHALID USTA
CA/2018/00790

DRAWING NO- 12012

COA REC. - 611 NORTH

11-11

DATE [illegible]

SCALE

1 INCH = 100 FT.



ARC
ARCHITECTS

ARCHITECTS | PLANNERS | DESIGNERS

F-16, PANWAR TOWER, GOVT.

PRESS ROAD, BEHIND
COLLECTORATE COMPLEX

COLLECTORATE COMPLEX,
BIKANER.

CONTACT: +91-9802479700

email- ustakhalid87@gmail.com