

Existing Site Plan Of Plot No.658
For Subdivision Map
Shown In Red Line
At Dada Bari L.I.G.H.Scheme
Near C.A.D.Circle Kota Taj.

Owner :-

Scale : 1" = 16' 0"



SH.NAROTTAM LAL SHARMA S/o SH.BHURA SINGH

PLOT No.658/1 :- 50' 0" x 130' 0" = 6500' 0" Sq.ft


PLOT No.658/2 :- 50' 0" x 130' 0" = 6500' 0" Sq.ft

TOTAL PLOT AREA

100' 0" x 130' 0" = 13000' 0" Sq.ft

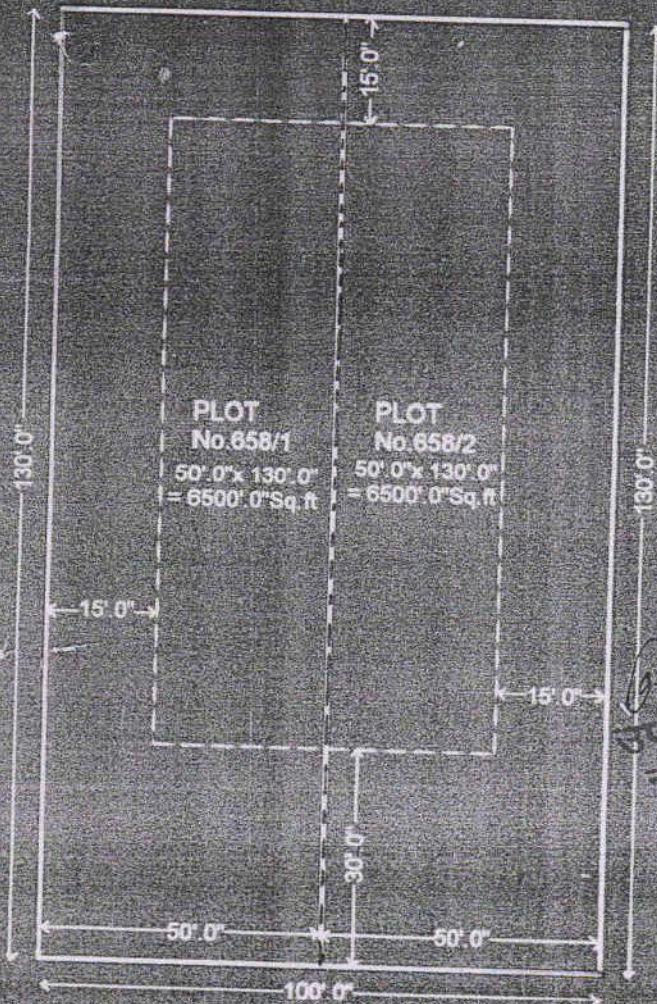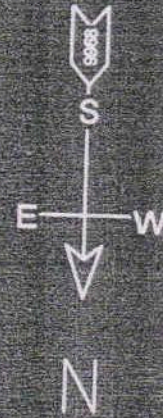

PLAN

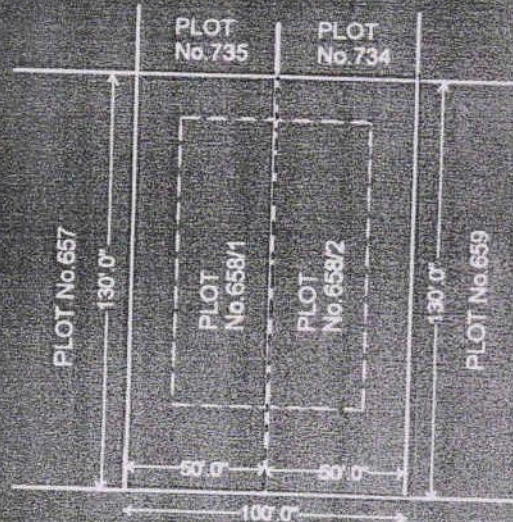

ROAD 98' 0" WIDE

SITE PLAN

उपनिवेश, कोटा

कमि. अभियन्ता,
नगर निगम, कोटा

Magsood Hasan

Civil Draft Man

License holder

Nagar Niigam, Kota

Reg-2012-13

Sig. Of Owner