
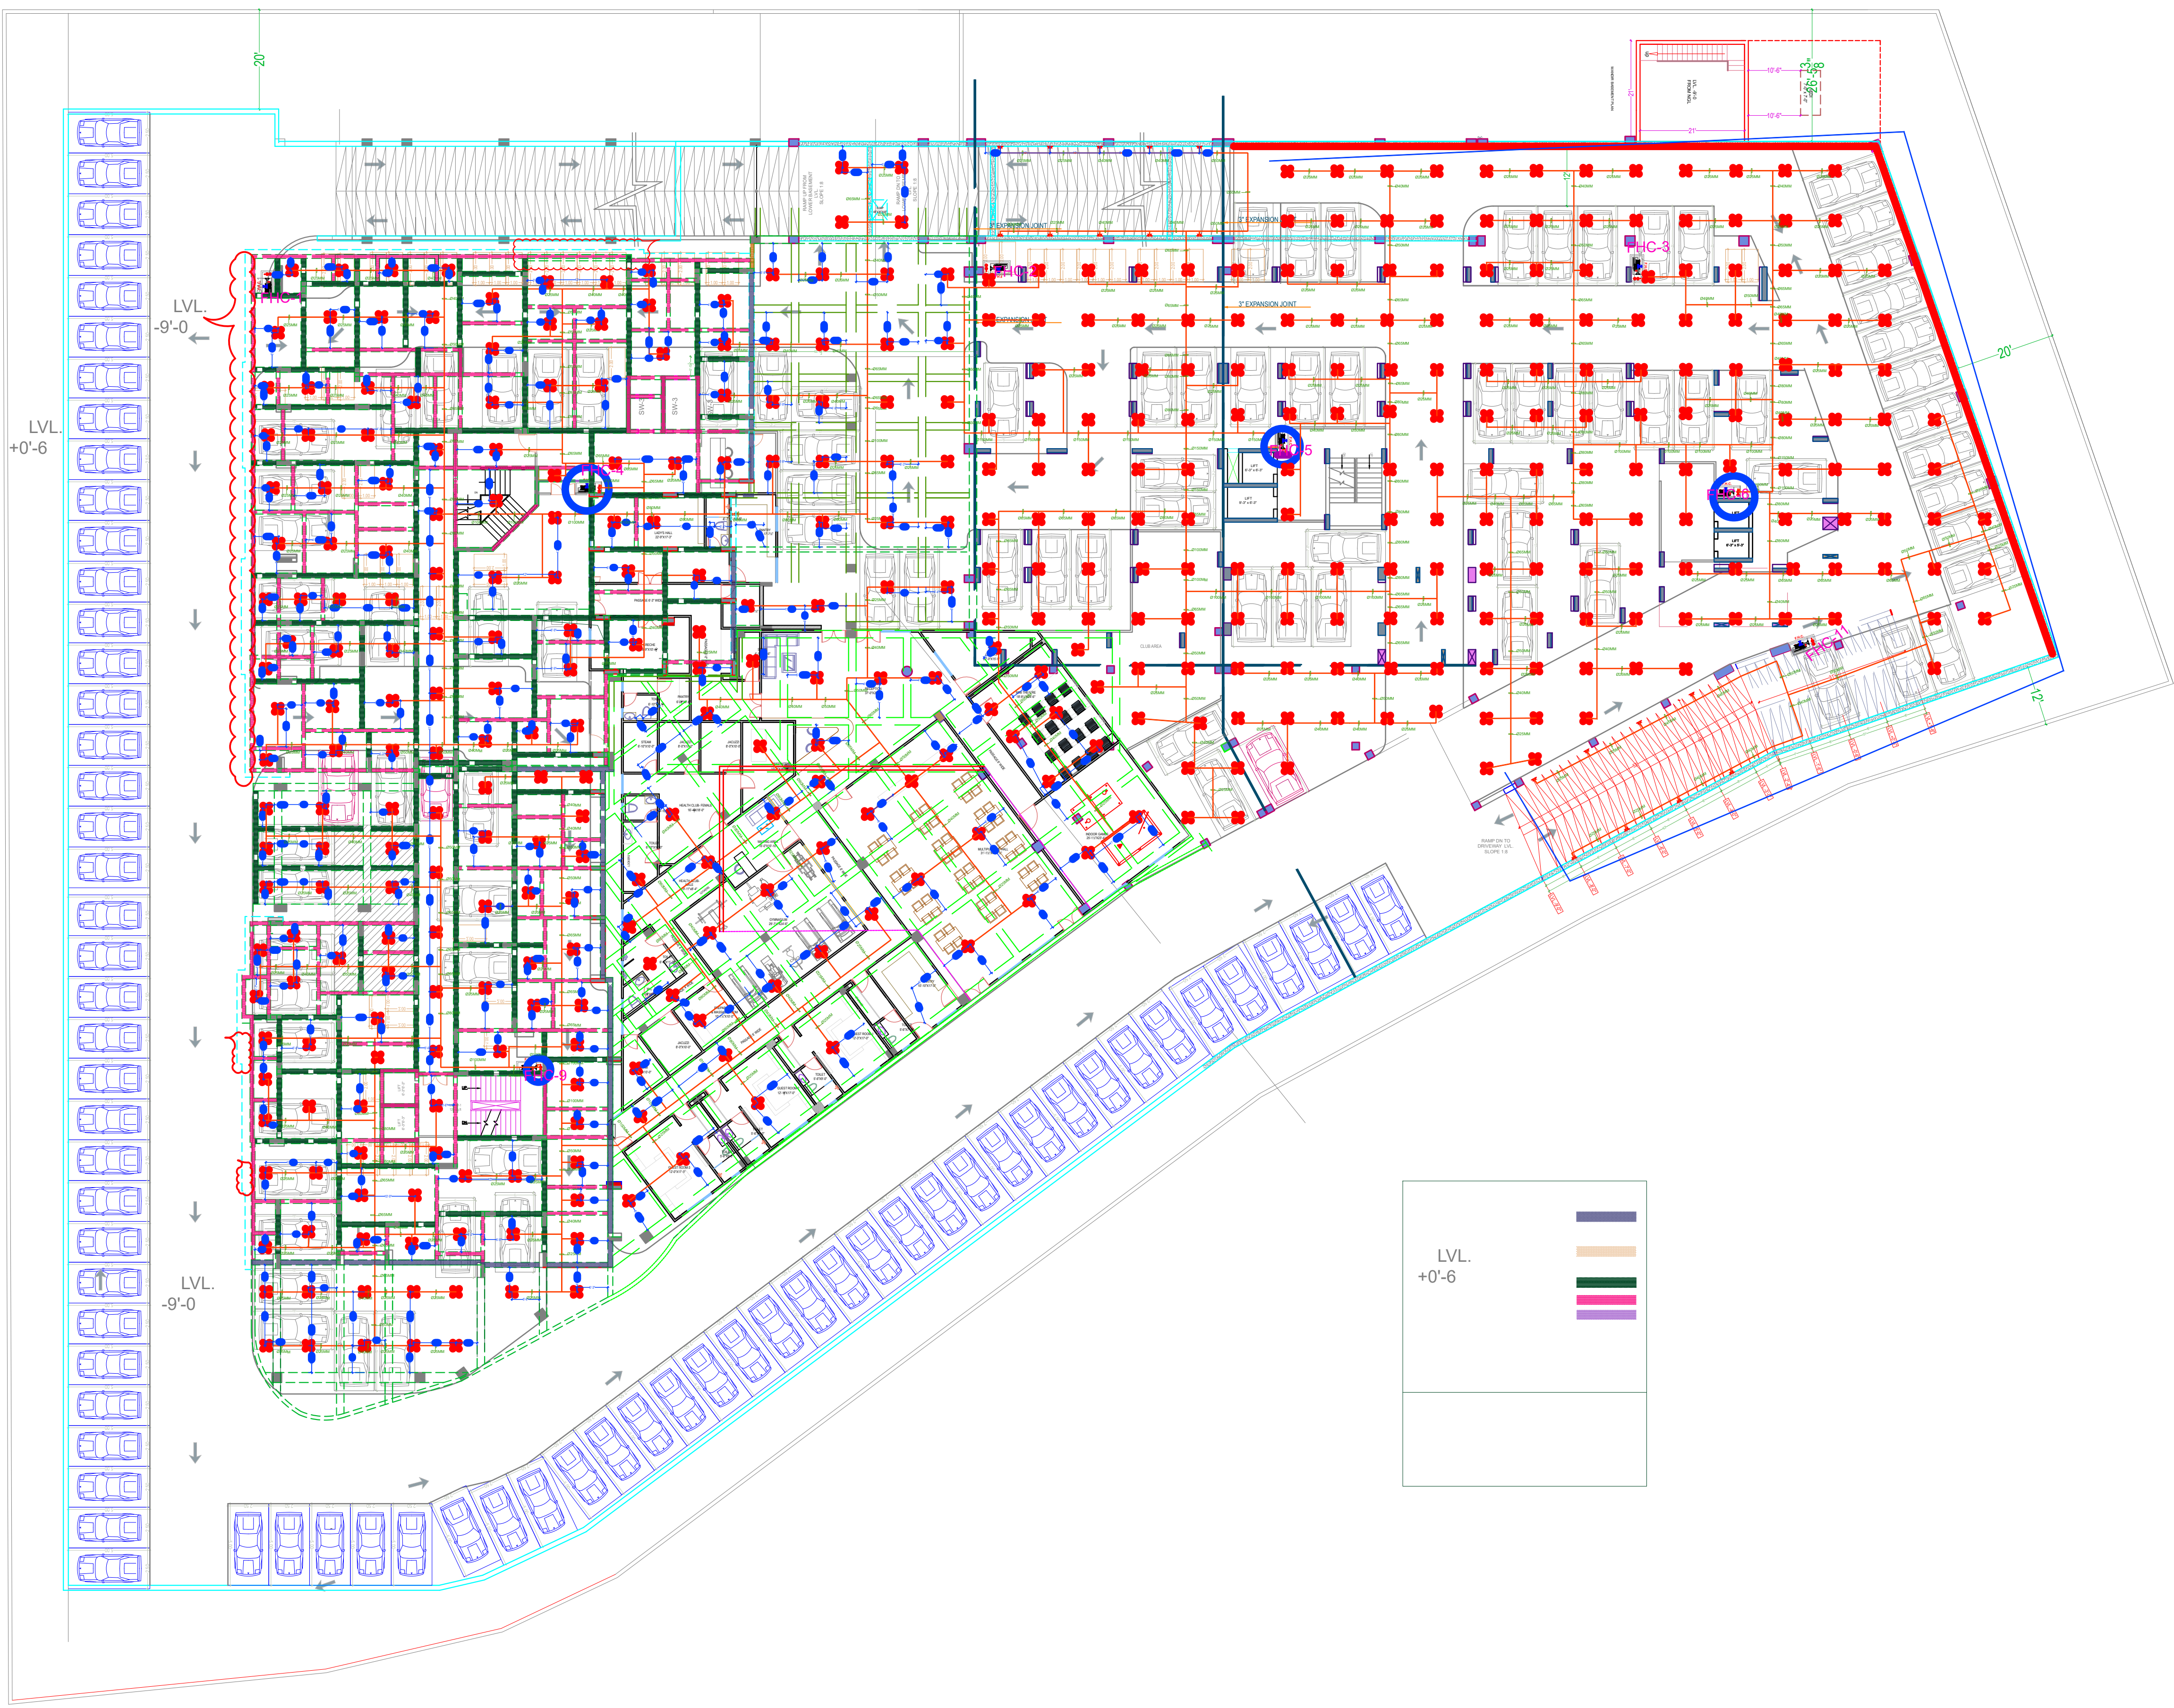


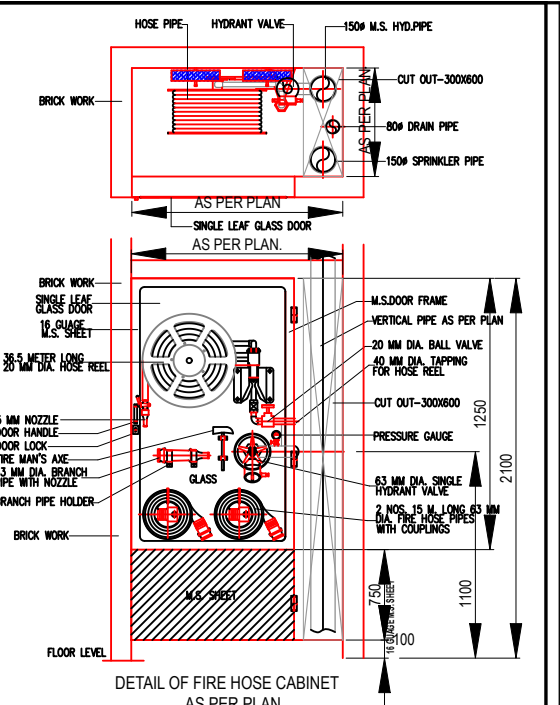

LEGEND - FIRE

S.NO.	SYMBOL	DESCRIPTION OF ITEM
1		UPRIGHT SPRINKLER
2		PENDENT TYPE SPRINKLER
3		SIDE WALL TYPE SPRINKLER
4		FIRE PIPE
5		FIRE HYDRANT

REV. NO.	DESCRIPTION TO REVISION	REV. BY	DATE
-	-	-	-
-	-	-	-
STRUCTURAL CONSULTANTS:-

SG STRUCTURES
A-36, 1ST FLOOR, SUNDER SINGH BANDARI NAGAR,
SWEJ FARM, NEW SANGANER ROAD, JAIPUR-302019
E-mail: sg.structures@gmail.com
Tel: 09772202219, 0141-2297076

ARCHITECT

Tushar Sogani Designs Pvt. Ltd.
architects 'n' designers
Studio :- 400, F-72, "SURYODAY", Subhash Marg,
Bagadiya Bhawan, C-Scheme, Jaipur-302001
TEL: +91-141-4004560, 4004537
email: studio@tsdplarch.com
website : www.tsdplarch.com

SUDHIR MATHUR
M.E.P.F. CONSULTANT
B.E. MECHANICAL

PROJECT NAME

TERREZA GREEN

CLIENT NAME

DWG TITLE

TERREZA GREEN LOWER
GROUND FLOOR FIRE
FIGHTING PLAN

DWG STATUS

AS BUILT COMPLETION
DRAWING

MEP CONSULTANTS

SHRESHTHA
the heartbeat of your building

DEALT BY:

MEMANSHA

DRAWING NO.:

NTS

CHECKED BY:

MEMANSHA

DATE:

02-10-2024

DIRECTION:

