



LAY OUT PLAN OF "RADHA GOVIND VIHAR"

AT VILLAGE KESYAWALA TEHSIL SANGANER, JAIPUR. UNDER

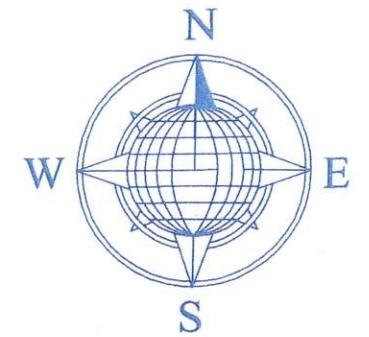

JDA APPROVED
RADHA RANI VIHAR

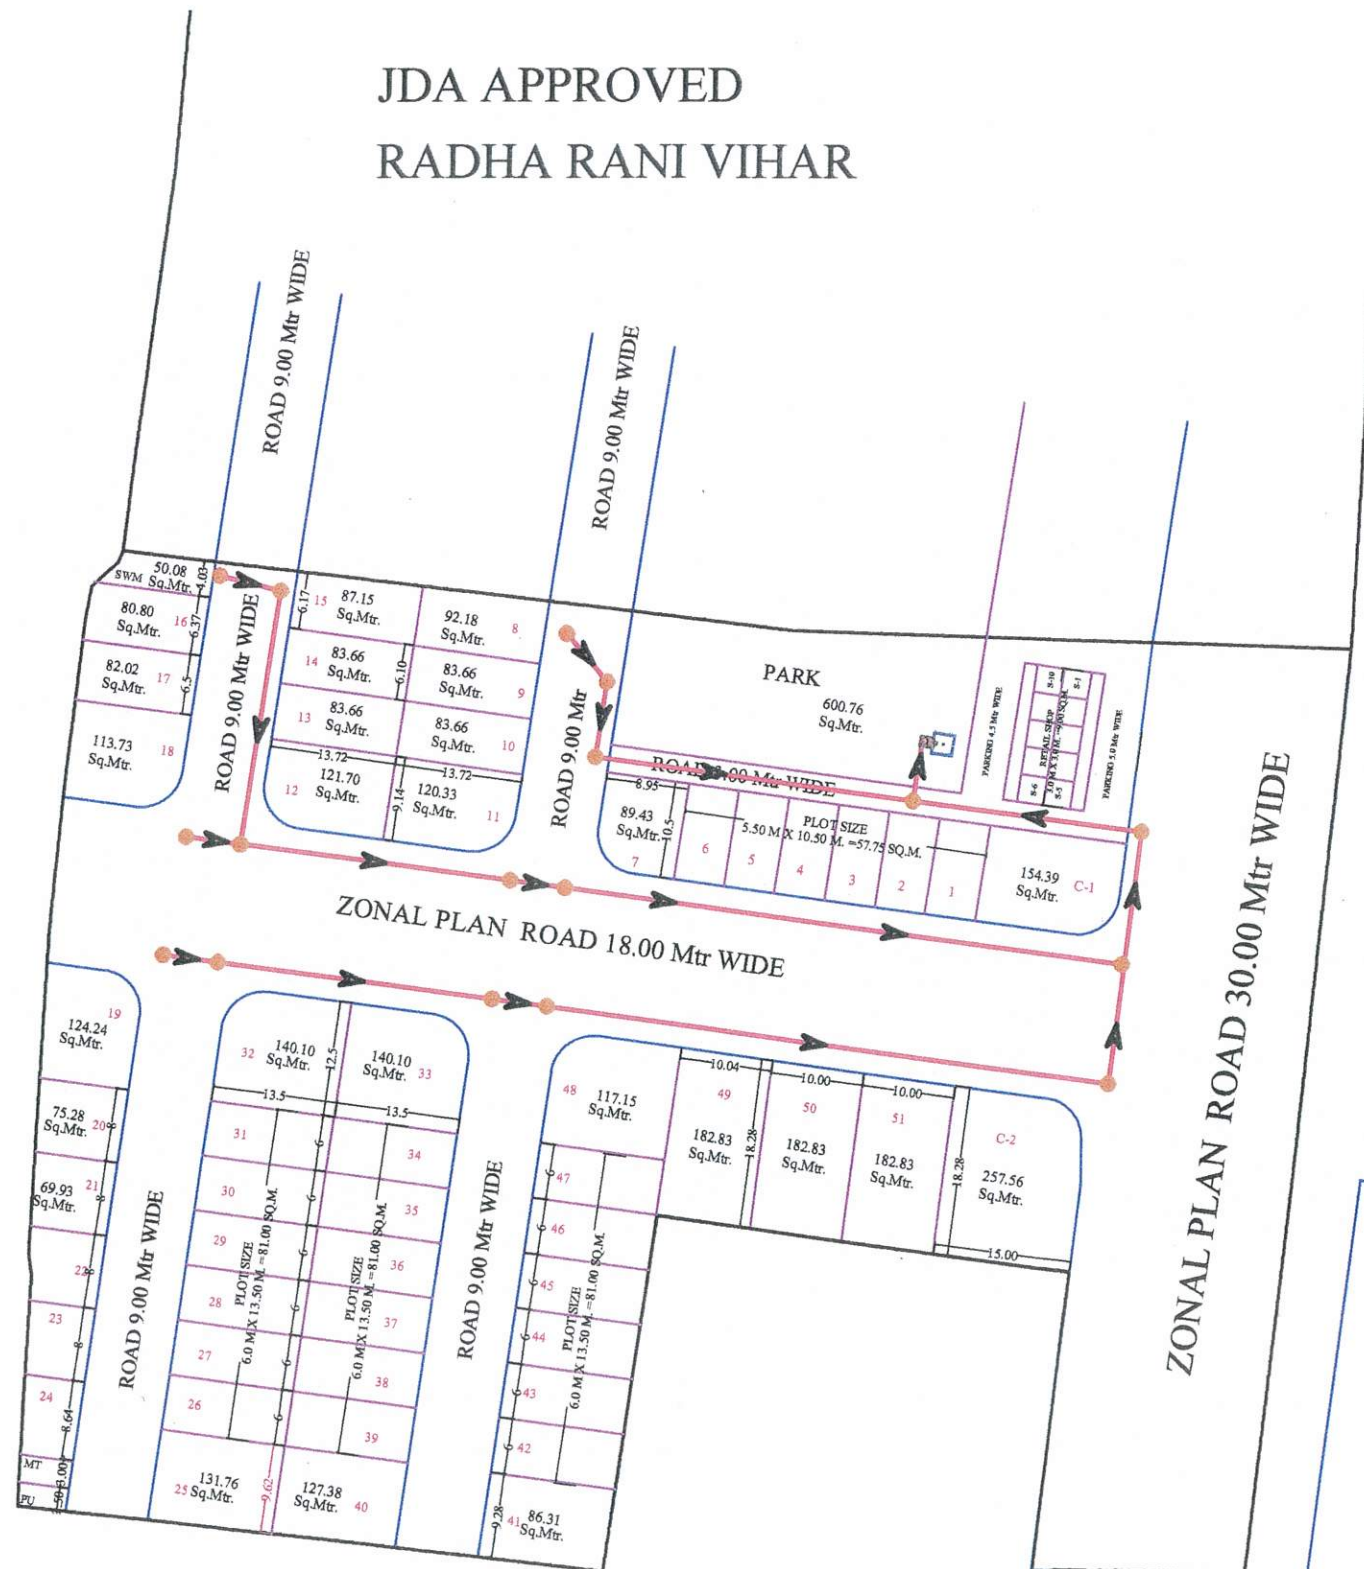

LEGEND :-

1.	RAIN WATER LINE	200 MM	
2.	MAIN HOLE		
3.	HARVESTING CHAMBER		
4.	MAIN HOLE DEPTH		0.00
5.	LENGTH		0.00

DWG. TITLE
AS BUILT DRG. OF RAIN WATER LINE IN RADHA GOVIND VIHAR
AT VILLAGE- KESYAWAL TEHSIL SANGANER, JAIPUR.
UNDER KHASRA NO. 111, 112, 911/113, 114, 115/1

PROJECT :- JDA APPROVED
RADHA GOVIND VIHAR
AT VILLAGE KESYAWAL, TEHSIL SANGANER, JAIPUR.

