




Premittium Residential Township Government approved

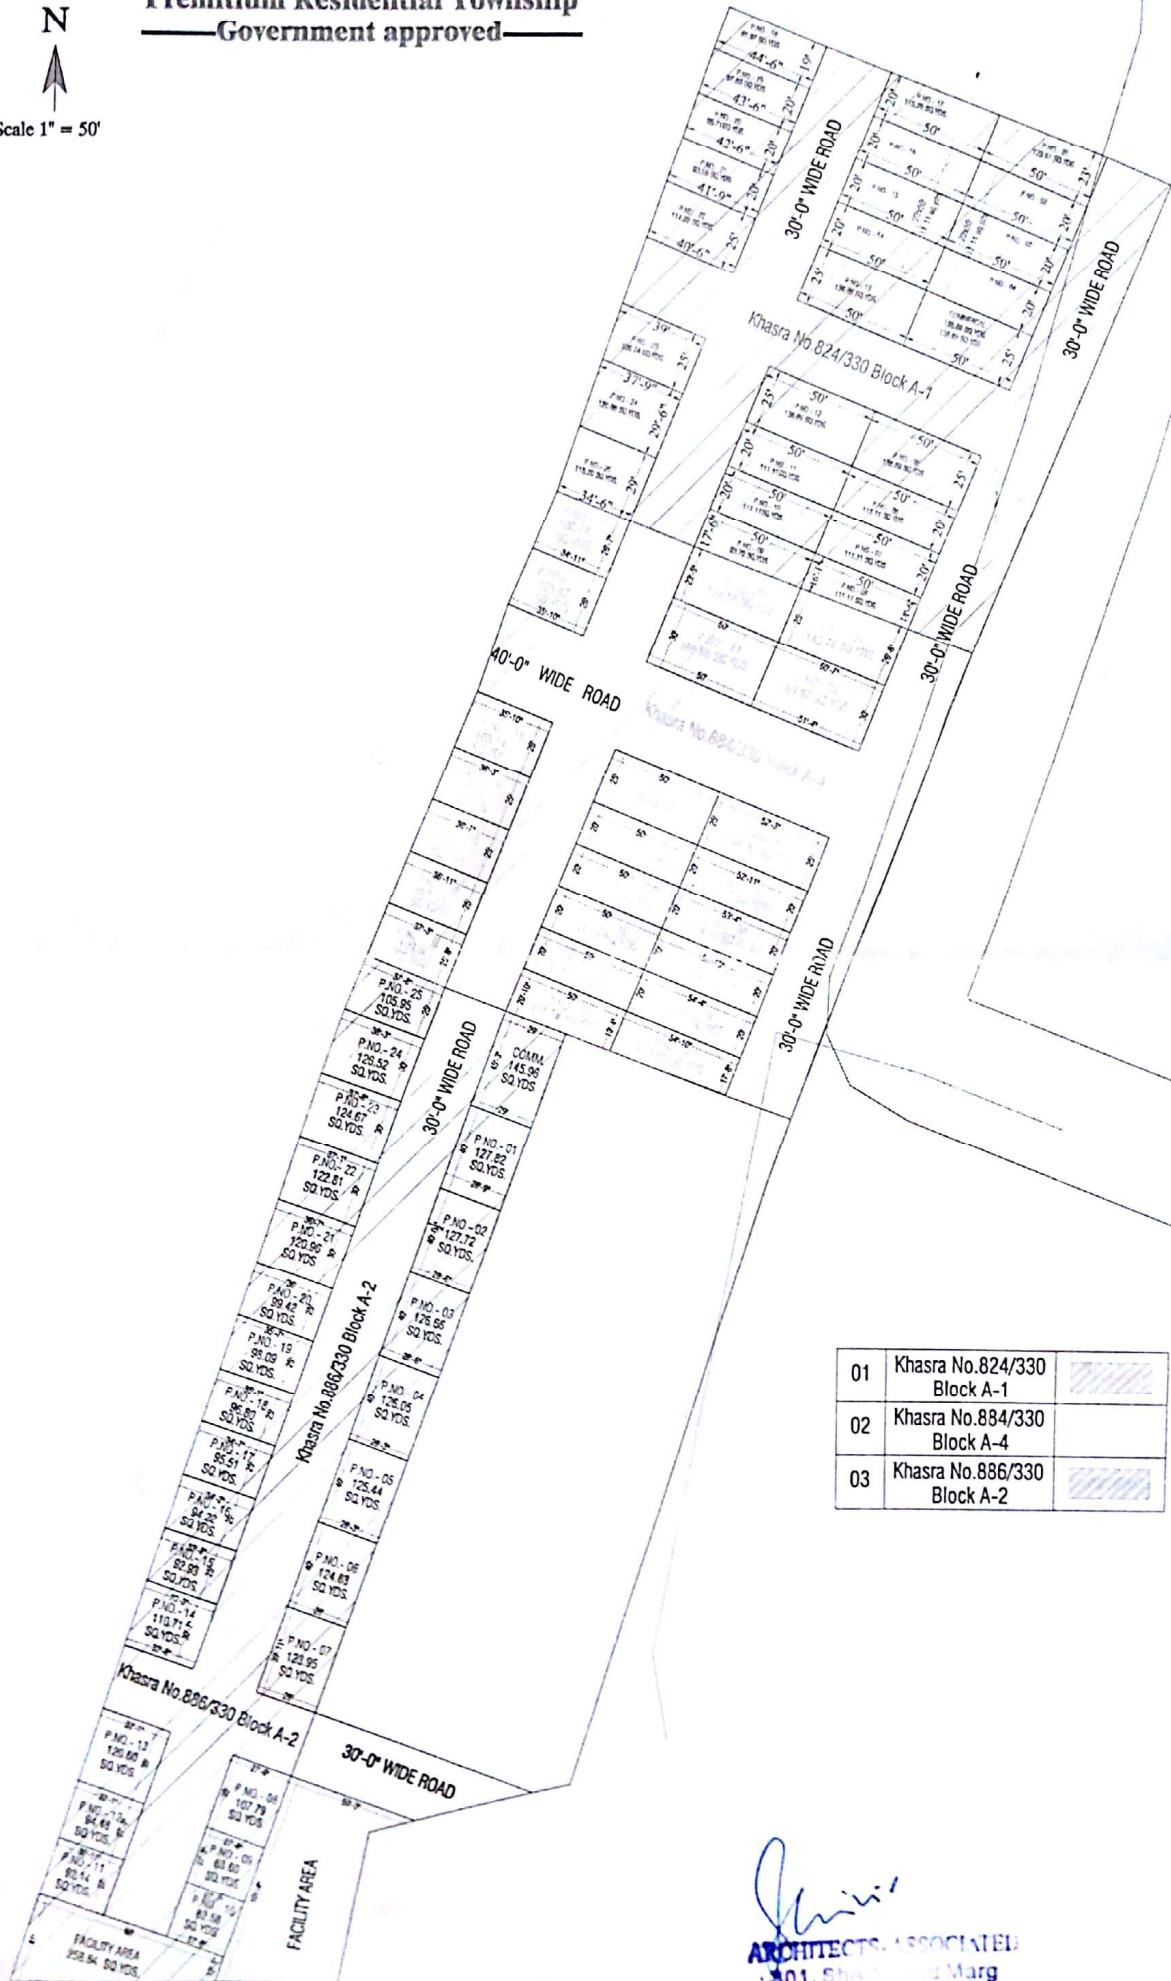

01	Khasra No.824/330 Block A-1	

Signature
ARCHITECTS ASSOCIATED
 301, Shree Ji Marg
 Rajmangalpur
 01/10/2018

SCALE: 1"=80'

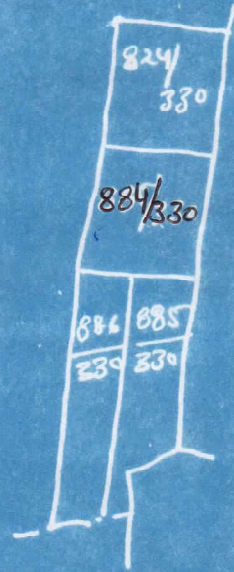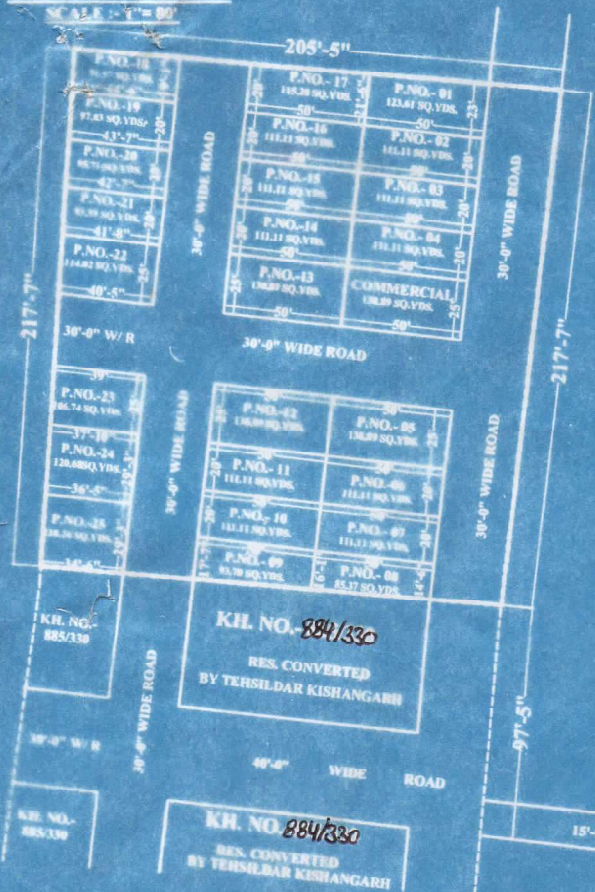

11. एकात्म में प्रस्तावित योजना
विभिन्न अङ्गों पर लेखों
की उपर लेखी भूमि में लेखी
अथ कुच्छेदी
8/6/15


{ LAND USE ANALYSIS }		
LAND USE	AREA IN SQ.YDS.	PERCENTAGE
01. <u>RESIDENTIAL PLOTS</u>	2784.53 SQ.YDS.	55.63 %
02. <u>ROADS</u>	1916.58 SQ.YDS.	39.59 %
03. <u>COMMERCIAL</u>	138.89 SQ.YDS.	04.78 %
<u>TOTAL LAND AREA</u>	4840.00 SQ.YDS.	100.00 %

NOTE:-
1. PROPOSED SITE SHOWN IN RED
2. TOTAL AREA OF LAND:- 8AKRA 02 BIGHA 05BISWA
= 4540.00 SQ.YDS. / 4046.72 SQ.MTR.

SIGN. APPLICANT

LAY OUT PLAN OF KR.NO. 224330 RAKBA 02 BIGHA 10 BISWA 10 LAGE MUNDOTI
TEHSIL KISHANGARH DISTT. AJMER
APPLY FOR :- RESIDENTIAL CONVERSION
APPLICANT :- SHRI AASHISH SINGH S/O SHRI KUNJBIHARI

SCALE: 1" = 80'

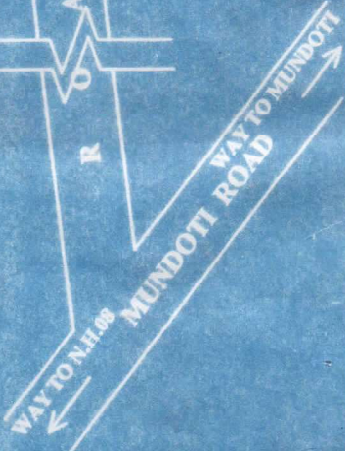

NOTE 1:-
PROPOSED SITE SHOWN IN RED




TEHSIL KISHANGARH DISTT. AJMER उपखण्ड अधिकारी
APPLY FOR :- RESIDENTIAL CONVERSION किशनगढ़ (अजमेर)
APPLICANT :- SUNIL KUMAR BHARGAVA HARSHANSHRAY निवेदनकर्ता
किशनगढ़ (अजमेर)

LOCATION MAP

SCALE :- 1" = 80'



KH.MP.

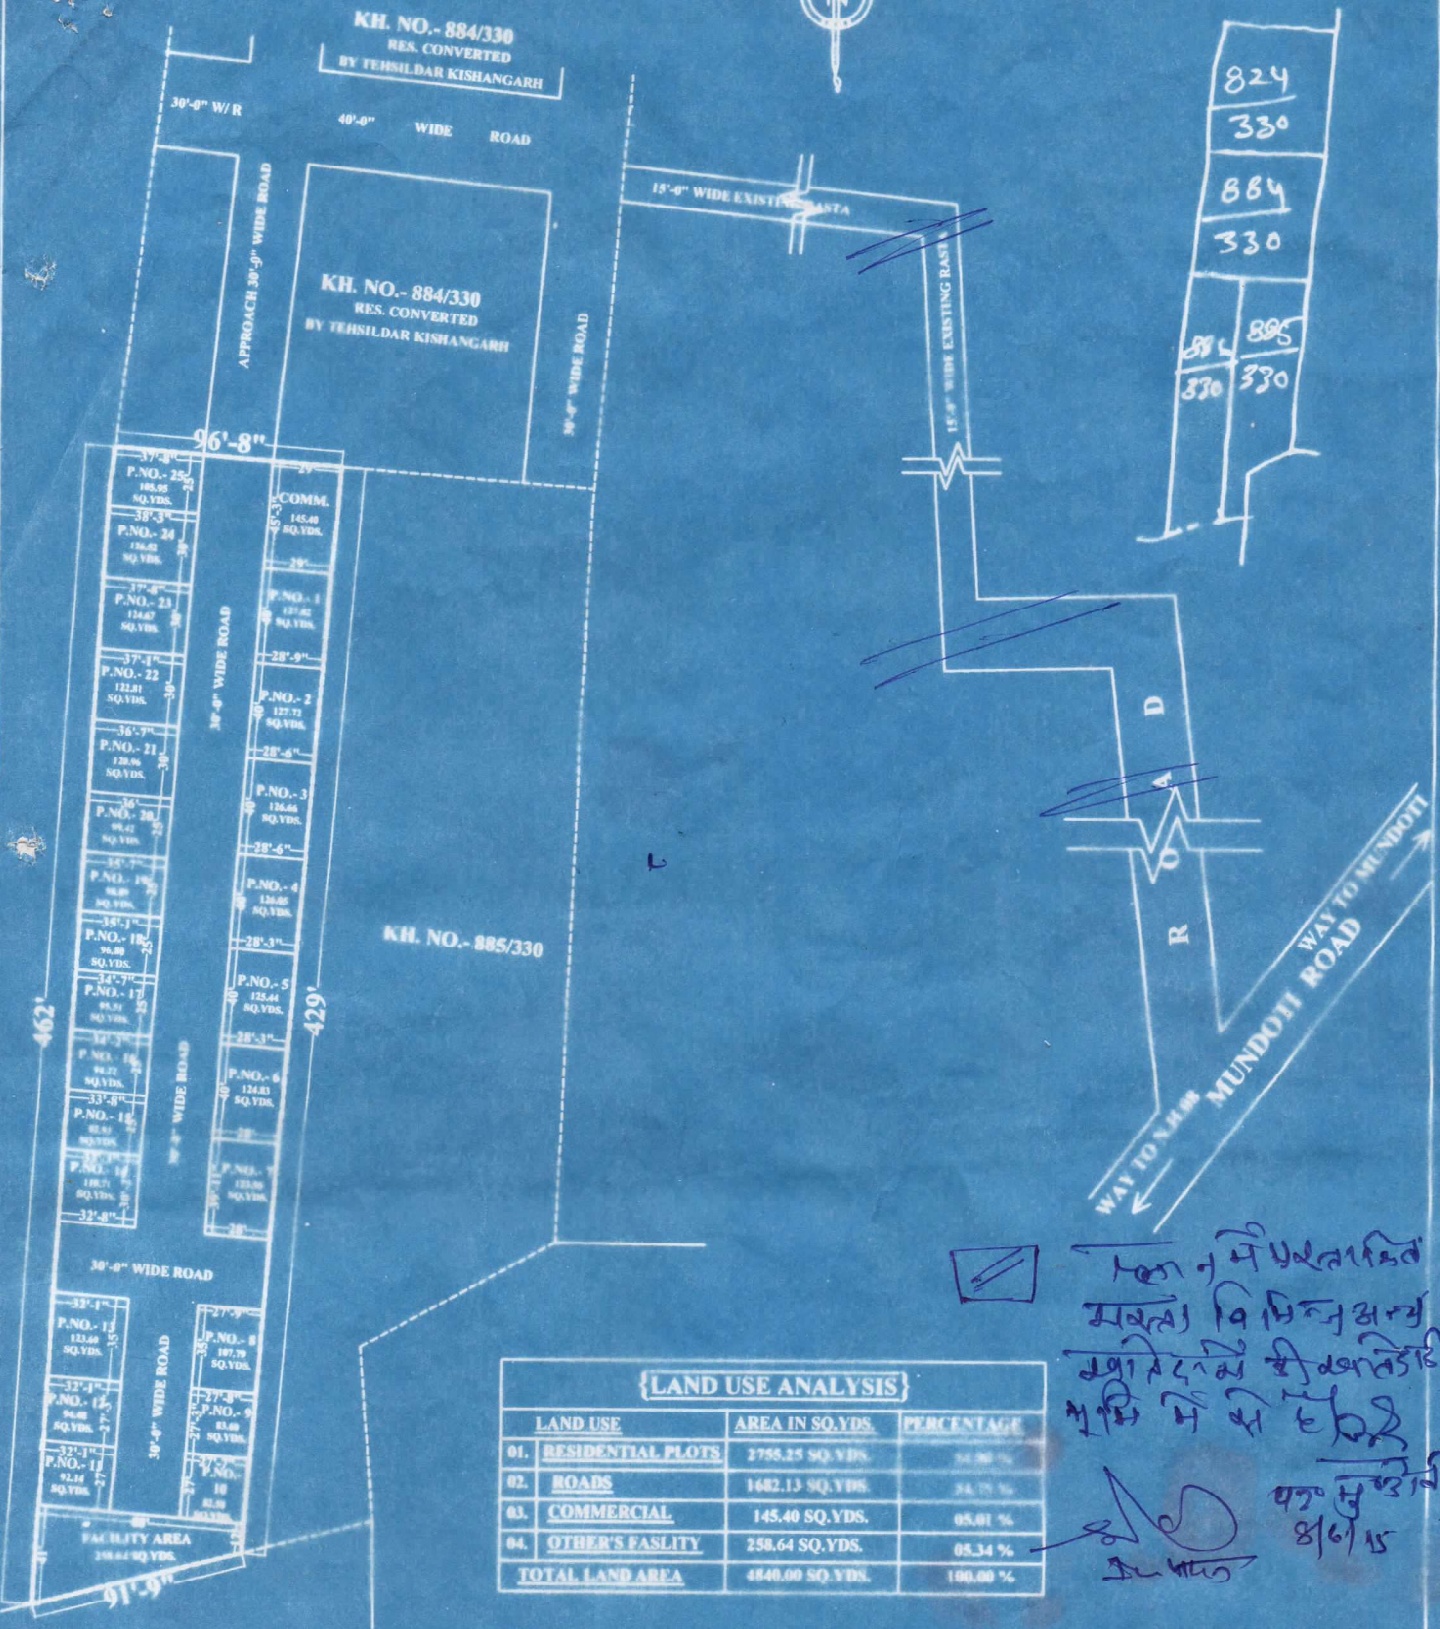

LAND USE ANALYSIS

LAND USE	AREA IN SQ.YDS.	PERCENTAGE
01. RESIDENTIAL PLOTS	2755.25 SQ.YDS.	54.98 %
02. ROADS	1682.13 SQ.YDS.	34.75 %
03. COMMERCIAL	145.40 SQ.YDS.	05.01 %
04. OTHER'S FASLITY	258.64 SQ.YDS.	05.34 %
TOTAL LAND AREA	4840.00 SQ.YDS.	100.00 %

NOTE :-

1. PROPOSED SITE SHOWN IN RED

2. TOTAL AREA OF LAND:- RAKBA 02 BIGHA 10 BISWA
= 4840.00 SQ.YDS. / 4046.72 SQ.MTR.


श्री कुलदीप पार्नामी
१६/१५

Shri Kuldeep Parnami

SIGN. APPLICANT

LAY OUT PLAN OF KH. NO. 884/330 RAKBA 02 BIGHA 10 BISWA AT VILLAGE MUNDOTI

TEHSIL KISHANGARH DIST. AJMER

APPLY FOR :- RESIDENTIAL CONVERSION

APPLICANT :- SHRI KULDEEP PARNAMI S/O SHRI SURENDRA KUMAR PARNAMI