


SITE PLAN
SCALE: 1"=100'

APPROVED CONVERTED KH.
NO. 542/2

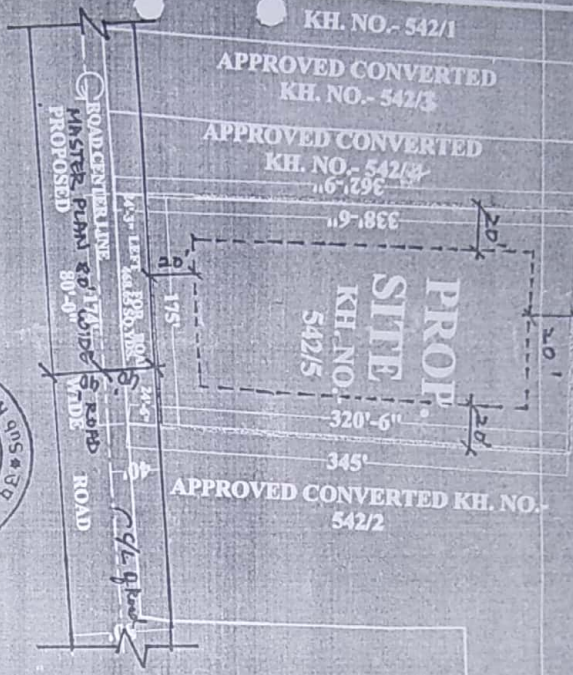

NOTE:
1. PROPOSED SITE SHOWN IN RED
2. AREA OF ROAD
3. LIT FOR ROAD AREA = 484.50 SQ. YDS.
4. TOTAL AREA OF PLOT = 5,700.00 SQ. YDS. / 320.00' x 175.00'
(30' BENCH TO BISHWA 03 BISHWA 03)



LAYOUT PLAN APPROVED IN BUDGETED
COMMITTEE MEETING ON 31/10/2017.

ARCHITECT
MOHD. AHMED
Ramesh Road, Gandhi Nagar
Madanganj - (Kishanganj)
9784180592, 9785152475

APPROVED AS PER CONDITIONS MENTIONED
IN PARA 4/RAH NO. 34/N.

SINGH OF APPLICANT

P.T. SURVEY PLAN SHOWING LAYOUT OF PLOT NO. 542/5
(RAKBA 03 BIGHA 13 BISHWA 03 EAST (KANSI) NEAR PATRAKAR
COLONY MADANGANJ- KISHANGARH
APPLICANT:- SMT REENA JAMAR W/O SHRI KALU SINGH JAMAR

KHARIDA PLAN
SCALE: 1"=330'



P.T. SURVEY PLAN
SCALE: 1"=200'



R.K. GIRLS
COLLAGE

APPROVED COLONY
KH. NO. 444

APPROVED CONVERTED COLONY
KH. NO. 542/2

APPROVED CONVERTED
PATRAKAR COLONY
KH. NO. 542/2

TO ANAND NAGAR
ROAD
APPLICANT

TO ANAND NAGAR
ROAD
APPLICANT

