


SUBSTATION AREA



REV. NO.	DESCRIPTION TO REVISION	REV. BY	DATE	STRUCTURAL CONSULTANTS	ARCHITECT	PROJECT NAME	DWG. TITLE	MEP CONSULTANTS	DEALT BY	CHECKED BY	DIRECTION
-	-	-	-	SG STRUCTURES A-36/1ST FLOOR, SINGAR SINGH BANDARI NAGAR, BWEI PARK, NEW SANGHER ROAD, JAIPUR-302019 TEL: 9872202219/0141-2297076	Tushar Sogani Designs Pvt. Ltd. architects 'n' designers Studio :- 400, F-72, 'SURYODAY', Subhash Marg, Bagadiya Bhawan, C-Scheme, Jaipur-302001 TEL: +91-141-4004560, 4004537 email: studio@tsdplarch.com website : www.tsdplarch.com	TERRAZA GREEN	TERRAZA GREEN GROUND FLOOR SUBSTATION AREA MARKING SITE PLAN.	SHRESHTHA the heartbeat of your building	DHEERAJ SHARMA	ROHIT SAINI	18-08-2022
-	-	-	-			CLIENT NAME	AS BUILT COMPLETION DRAWING		NTS	A-1	

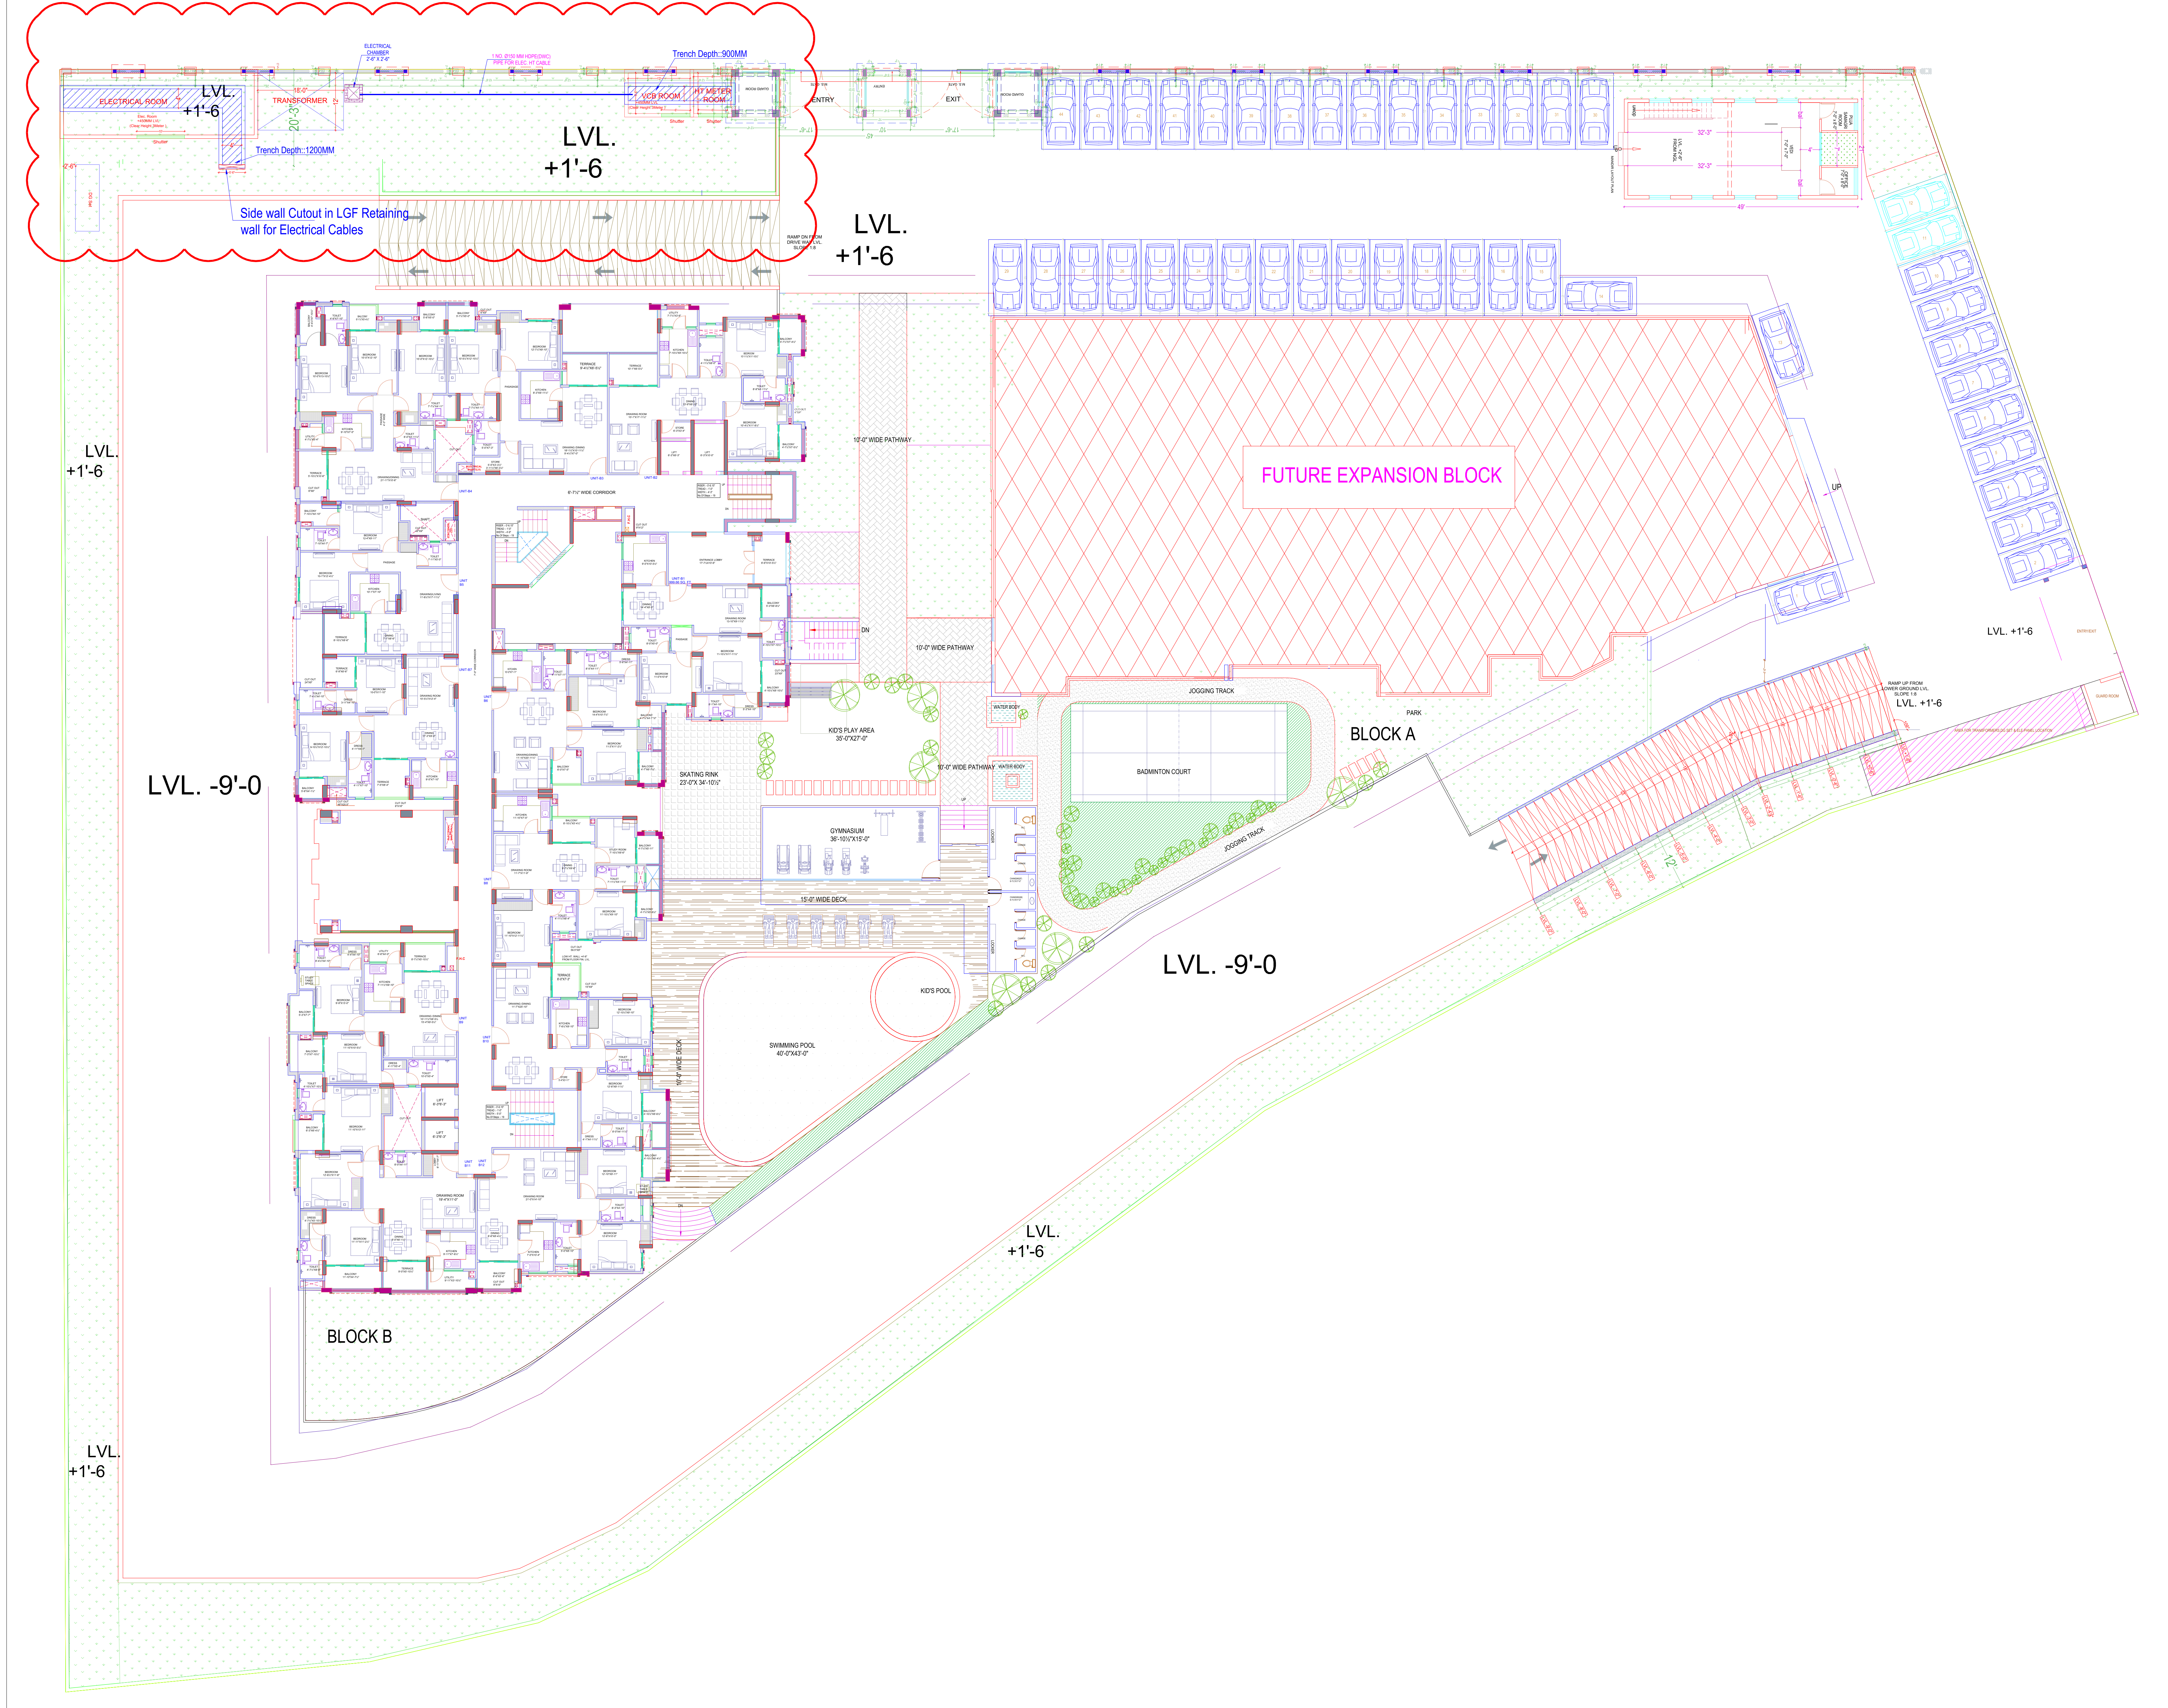