


SCALE: 1" = 80'

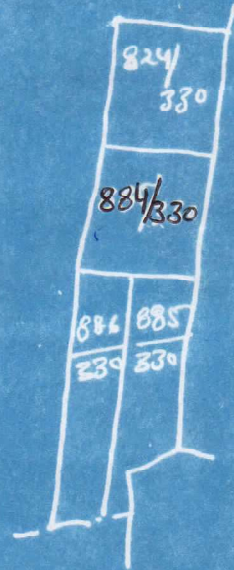

पत्रा में प्रस्तावित योजना
 विभिन्न अंगों पर लागू होने
 की योजना दाखिल भूमि में दो हज़ार
 एक सौ छठहत्तर
 अक्षर सुन्दरी
 ४/६/१५


NOTE:-
1. PROPOSED SITE SHOWN IN RED
2. TOTAL AREA OF LAND:- 8AKRA 02 BIGHA 05BISWA
= 4840.00 SQ.YDS. / 4046.72 SQ.MTR.

NOTE :-
1. PROPOSED SITE SHOWN IN RED
2. TOTAL AREA OF LAND:- RASRA 02 BIGHA 05BISWA
= 4040.00 SQ.YDS. / 4046.72 SQ.MTR.



SCALE: 1" = 80'

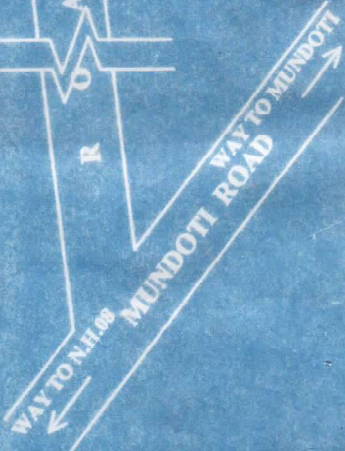










LOCATION MAP

SCALE :- 1" = 80'



KH.MP.

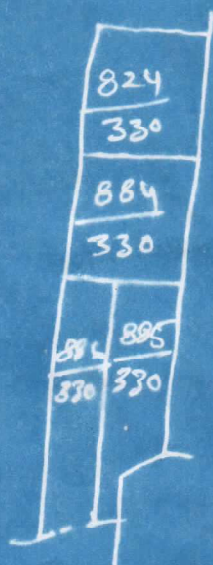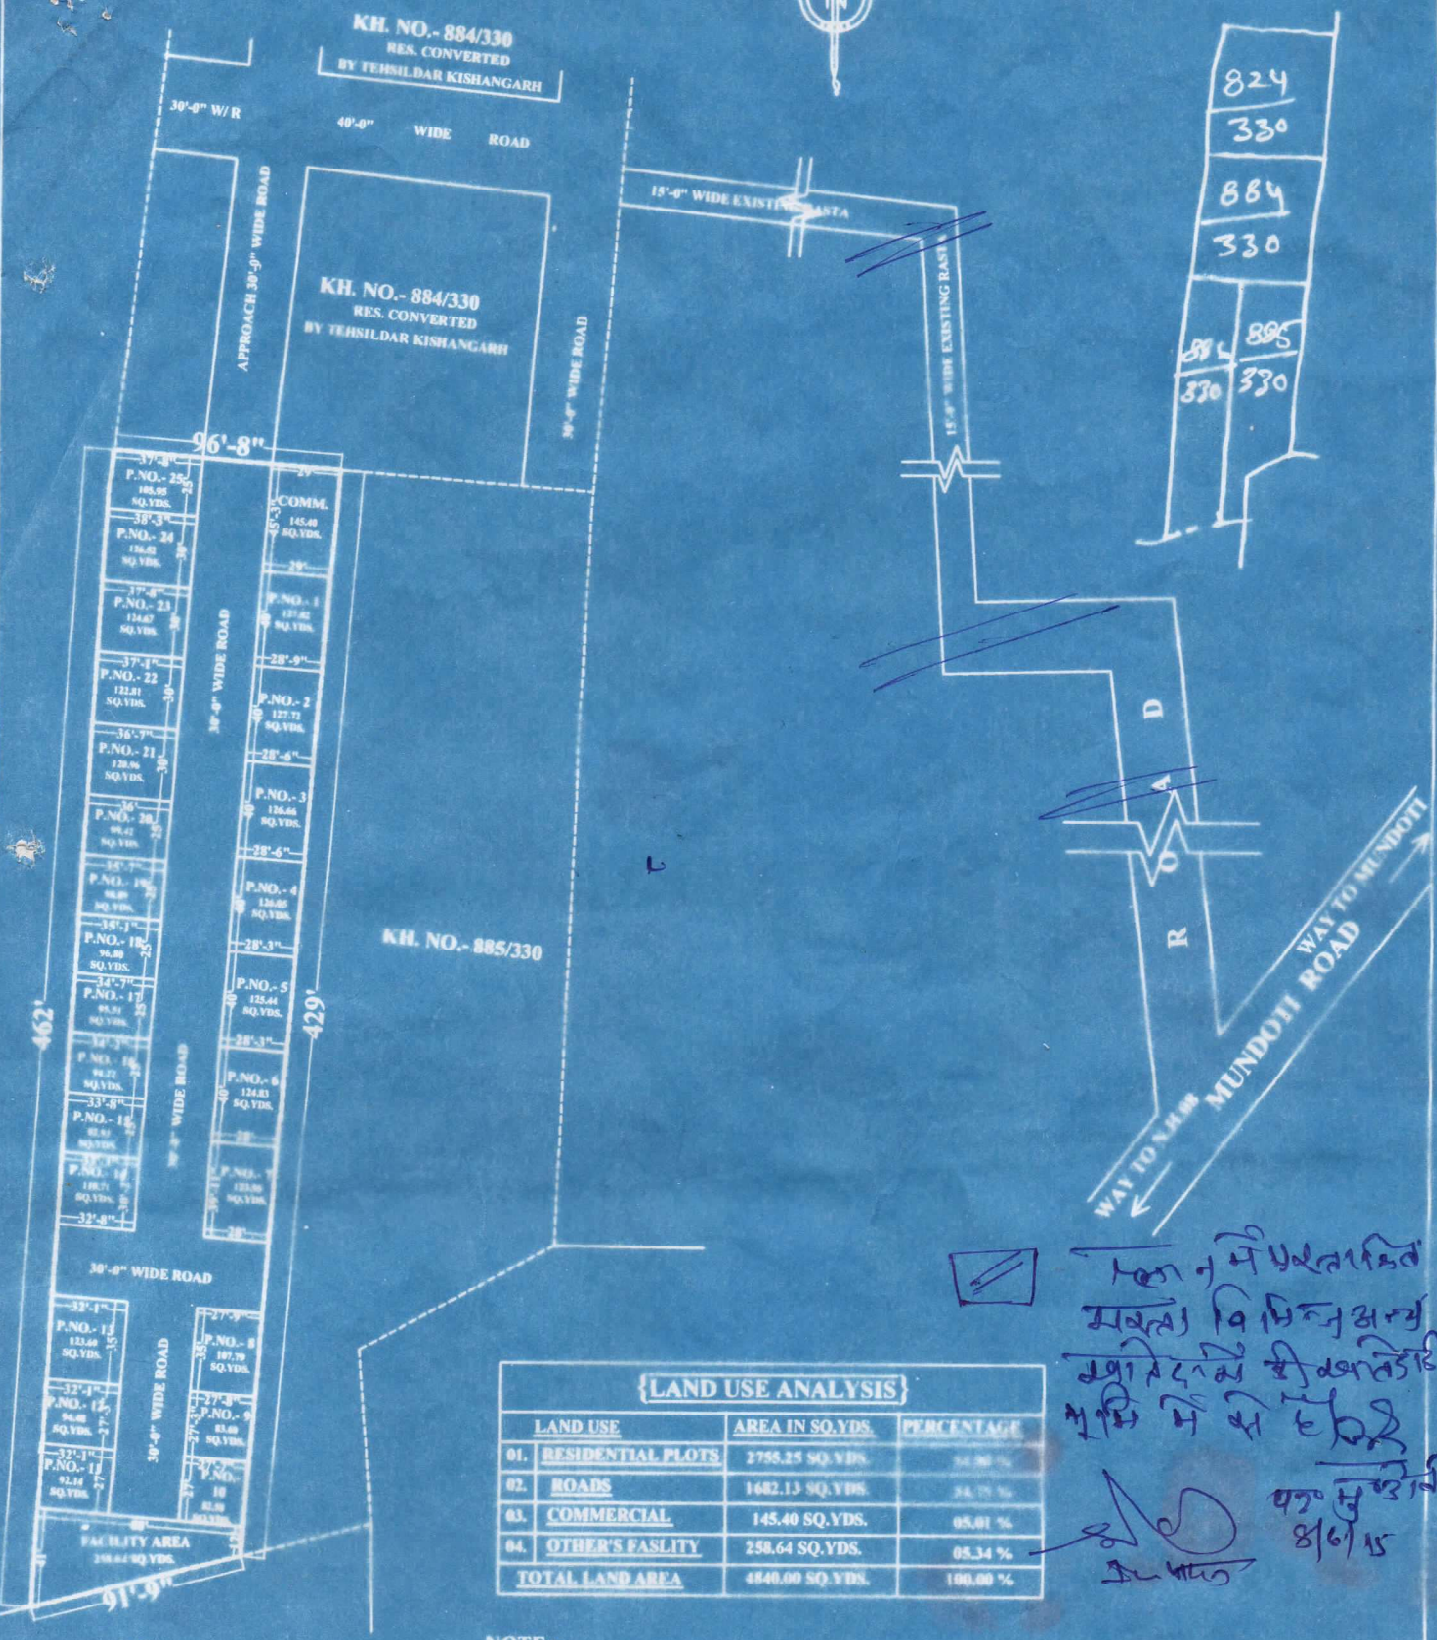

LAND USE ANALYSIS

LAND USE	AREA IN SQ.YDS.	PERCENTAGE
01. RESIDENTIAL PLOTS	2755.25 SQ.YDS.	74.90 %
02. ROADS	1682.13 SQ.YDS.	34.75 %
03. COMMERCIAL	145.40 SQ.YDS.	05.01 %
04. OTHER'S FASLITY	258.64 SQ.YDS.	05.34 %
TOTAL LAND AREA	4840.00 SQ.YDS.	100.00 %

NOTE :-
 1. PROPOSED SITE SHOWN IN RED
 2. TOTAL AREA OF LAND:- RAKBA 02 BIGHA 10 BISWA
 = 4840.00 SQ.YDS. / 4046.72 SQ.MTR.

हमने मंडोती में
 मंडोती विधानसभा
 क्षेत्र में ही विकास
 भूमि में से हरे
 श्रुत सुदेशी
 8/6/15

Shri Kuldeep Parnami

SIGN. APPLICANT

LAY OUT PLAN OF KH. NO. 884/330 RAKBA 02 BIGHA 10 BISWA AT VILLAGE MUNDOTI

TEHSIL KISHANGARH DIST. AJMER तहसील किशंगढ़ (अजमेर)

APPLY FOR :- RESIDENTIAL CONVERSION

APPLICANT :- SHRI KULDEEP PARNAMI S/O SHRI SURENDRA KUMAR PARNAMI

श्री सुदेशी
 8-6-15

C.S.

8/6/15